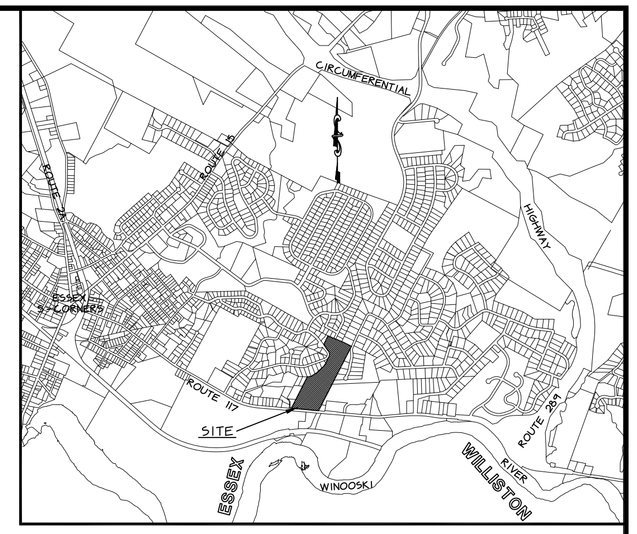

Location Plan

NTS

GRAPHIC SCALE

30 0 15 30 60 120

(IN FEET)

1 inch = 30 ft.

NOTES:

1. THIS PLAN IS FOR MARKETING PURPOSES ONLY AND SHALL NOT BE USED FOR CONSTRUCTION

THE CONTRACTOR SHALL NOTIFY "DIGSAFE" AT 1-888-DIG-SAFE PRIOR TO ANY EXCAVATION.

DATE	REVISION	BY
SURVEY: OTHER	■ RECORD DRAWING ☐ PRELIMINARY ☐ FINAL ☐ SKETCH/CONCEPT	DATE: 8/26/15
DESIGN: MJB		JOB#: 7072
DRAWN: SWH		FILE: 7072-S9
CHECKED: DWB		PLAN SHEET #: M
SCALE: 1"=30'		

O'LEARY-BURKE CIVIL ASSOCIATES, PLC
1 CORPORATE DRIVE, SUITE #1
ESSEX JCT., VT
PHONE: 879-9060
FAX: 878-9989
E-MAIL: obca@olearyburke.com

VILLAGE WALK

PLANNED RESIDENTIAL DEVELOPMENT

216 MAPLE STREET ESSEX JCT., VT

MARKETING PLAN

UNITS 36 - 48 (PHASE 1)